


**FINAL STOCK**

\* = No more can be supplied once stock is depleted

RED LINE Indicates NO LONGER AVAILABLE

Blue Text Indicates USE THIS NEW NUMBER

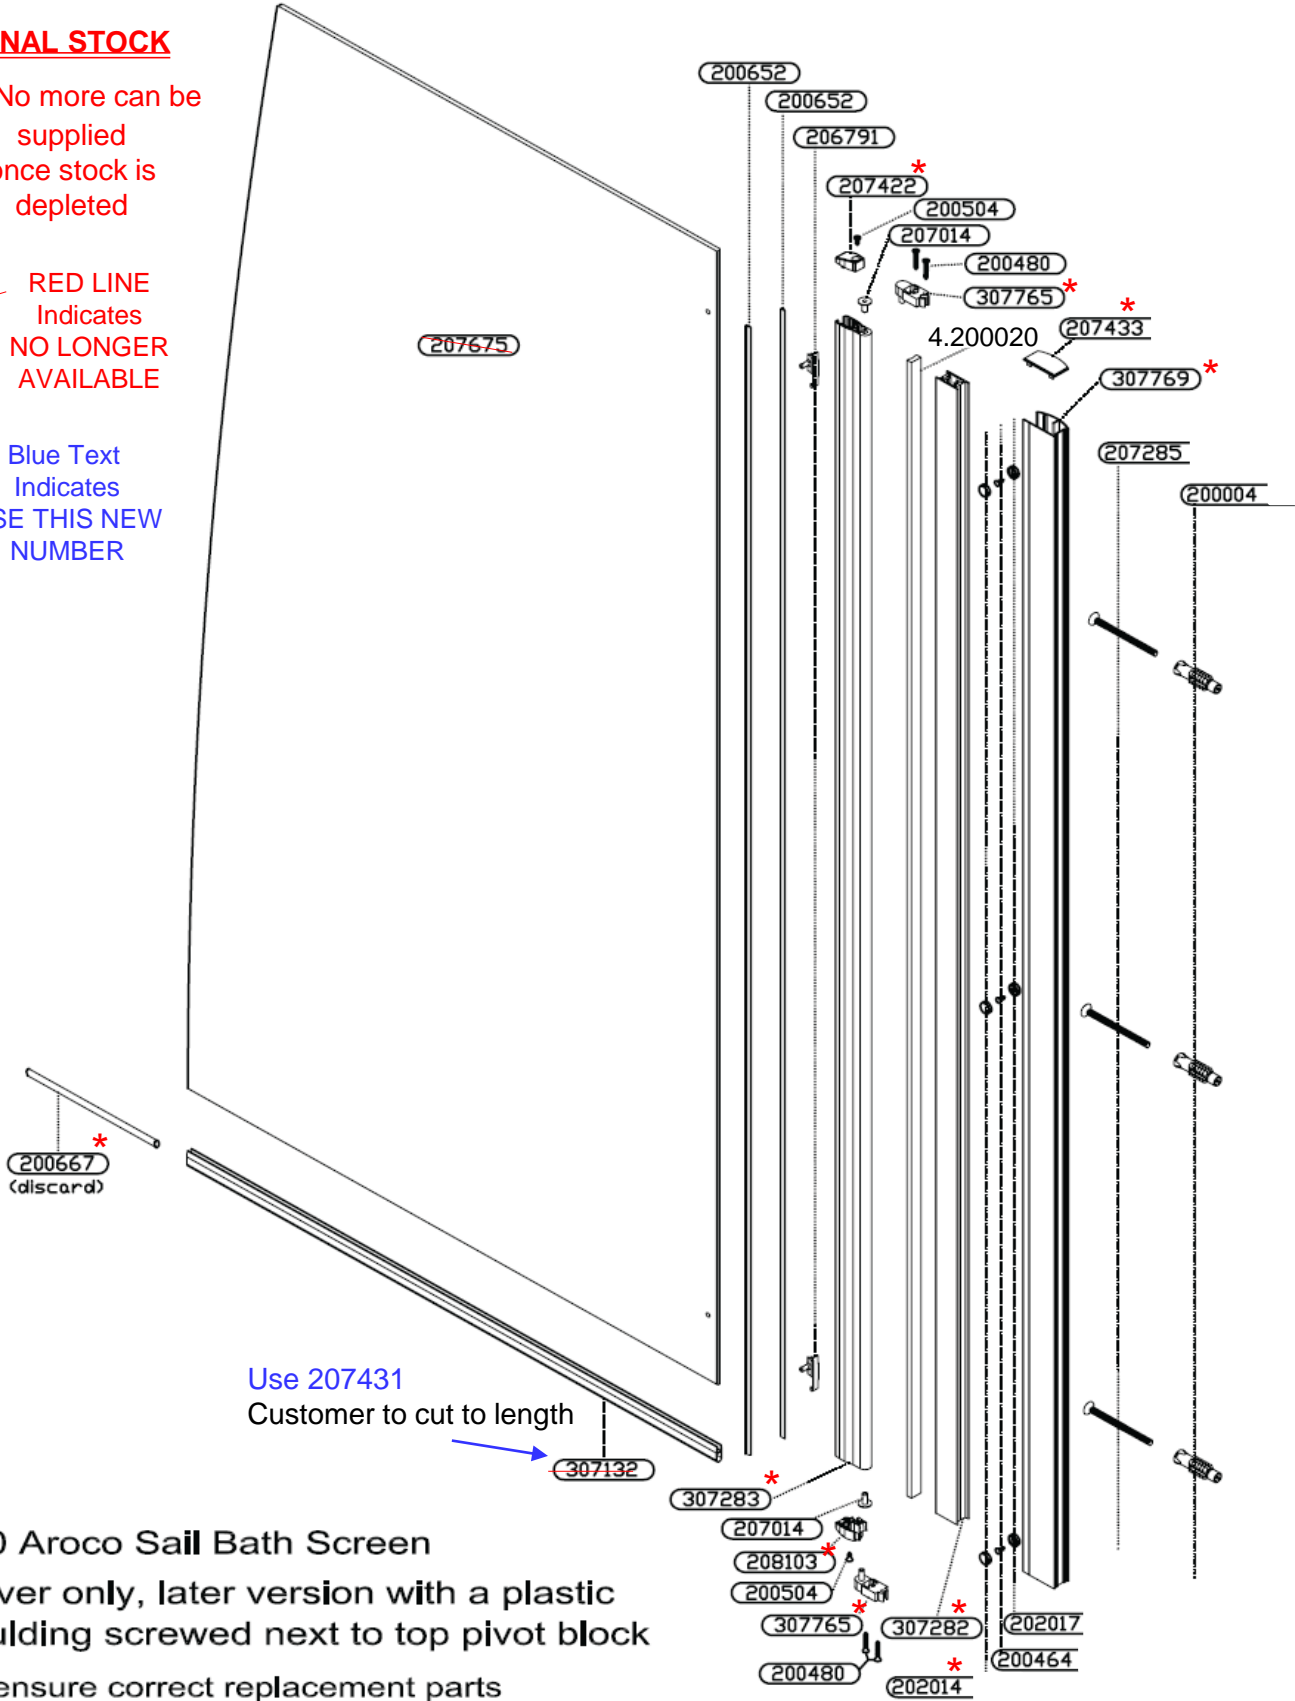

**850 Aroco Sail Bath Screen**  
- silver only, later version with a plastic moulding screwed next to top pivot block

To ensure correct replacement parts are sent be ready to quote the six digit part code from this drawing eg 307132

PP after a part means it is contained in the parts pack