


# 631 Prima Pivot Door 762

The codes here refer to the silver model. To ensure correct replacement parts are sent be ready to quote:

- The six digit part code from this drawing eg 304781
- The frame finish eg silver
- The unit size eg 762

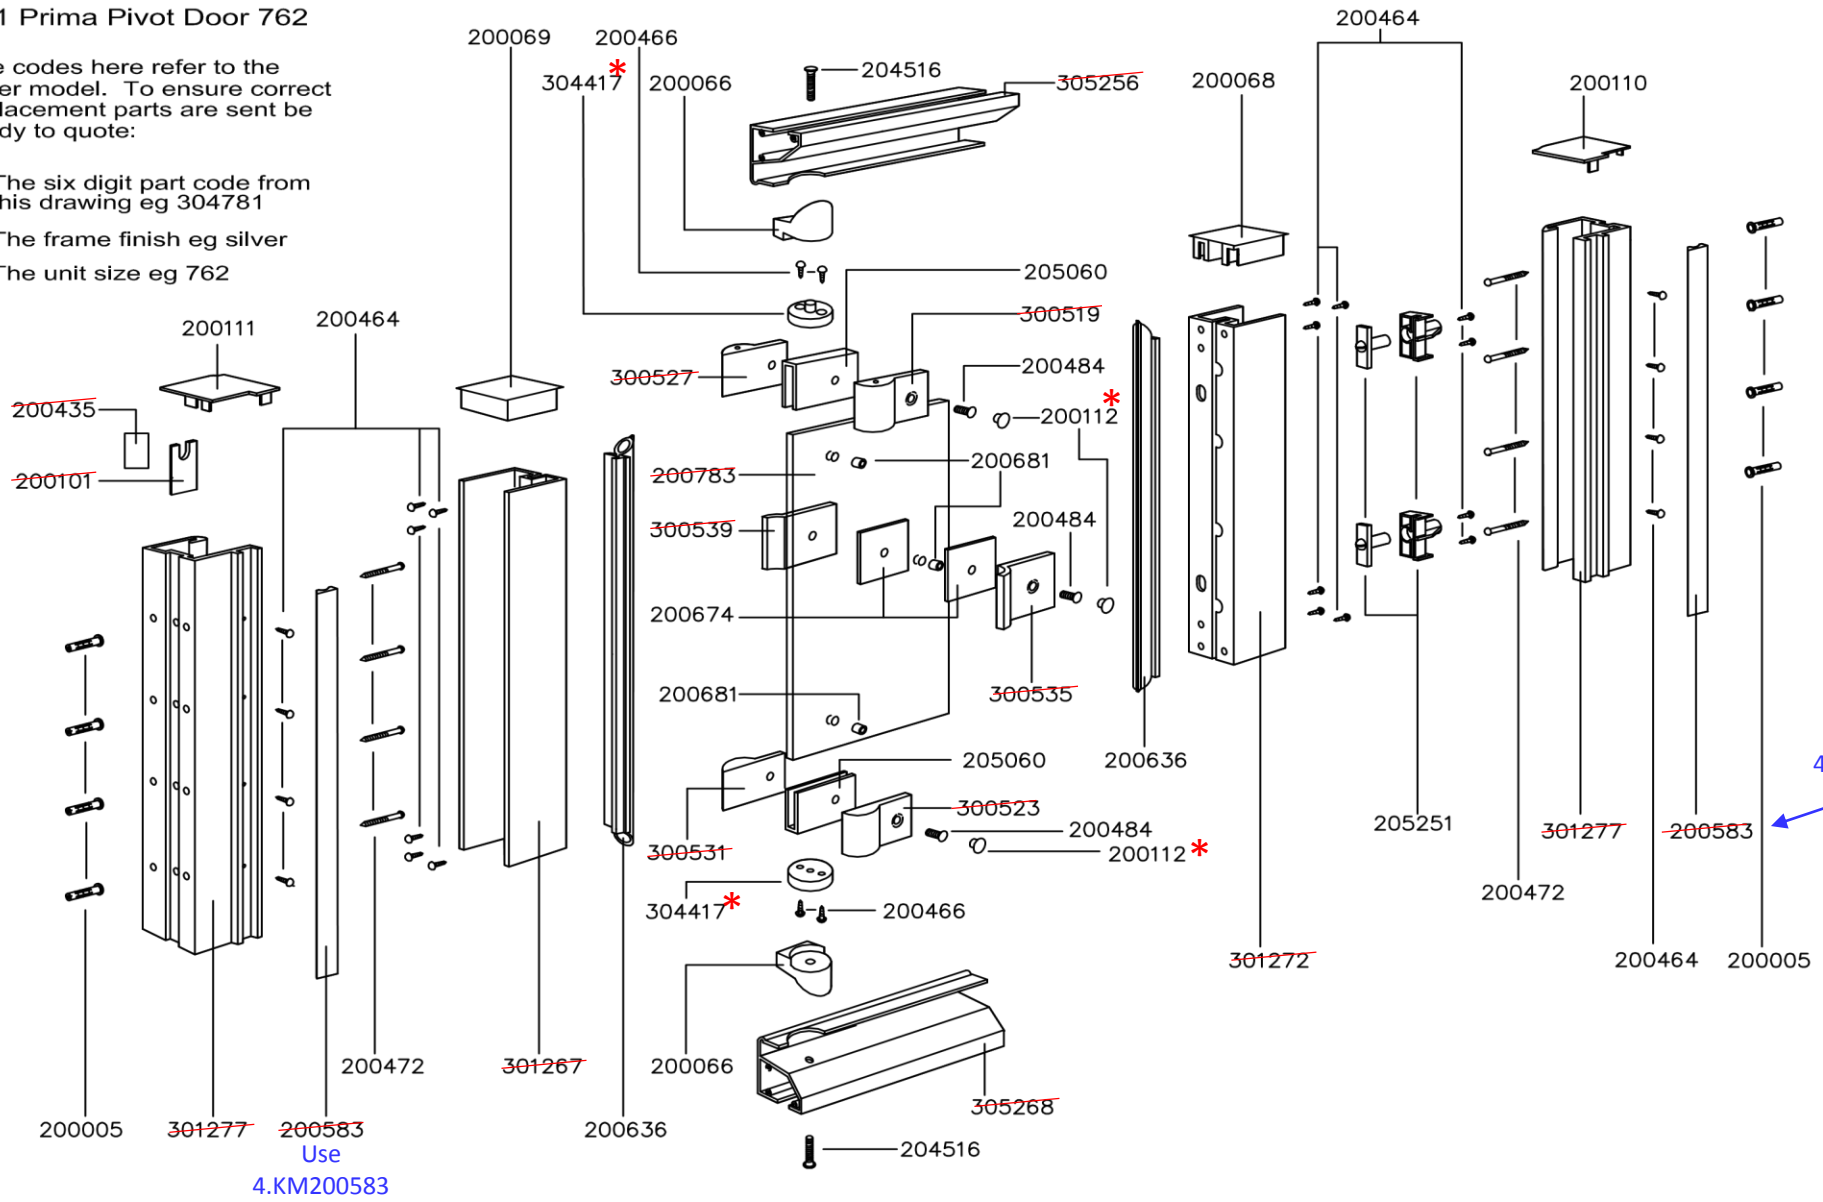

## FINAL STOCK

\* = No more can be supplied once stock is depleted

RED LINE Indicates NO LONGER AVAILABLE

Blue Text Indicates USE THIS NEW NUMBER

Use 4.KM200583