


FINAL STOCK
* = No more can be supplied
once stock is depleted

Blue Text
Indicates
USE THIS NEW NUMBER

RED LINE
Indicates
NO LONGER AVAILABLE

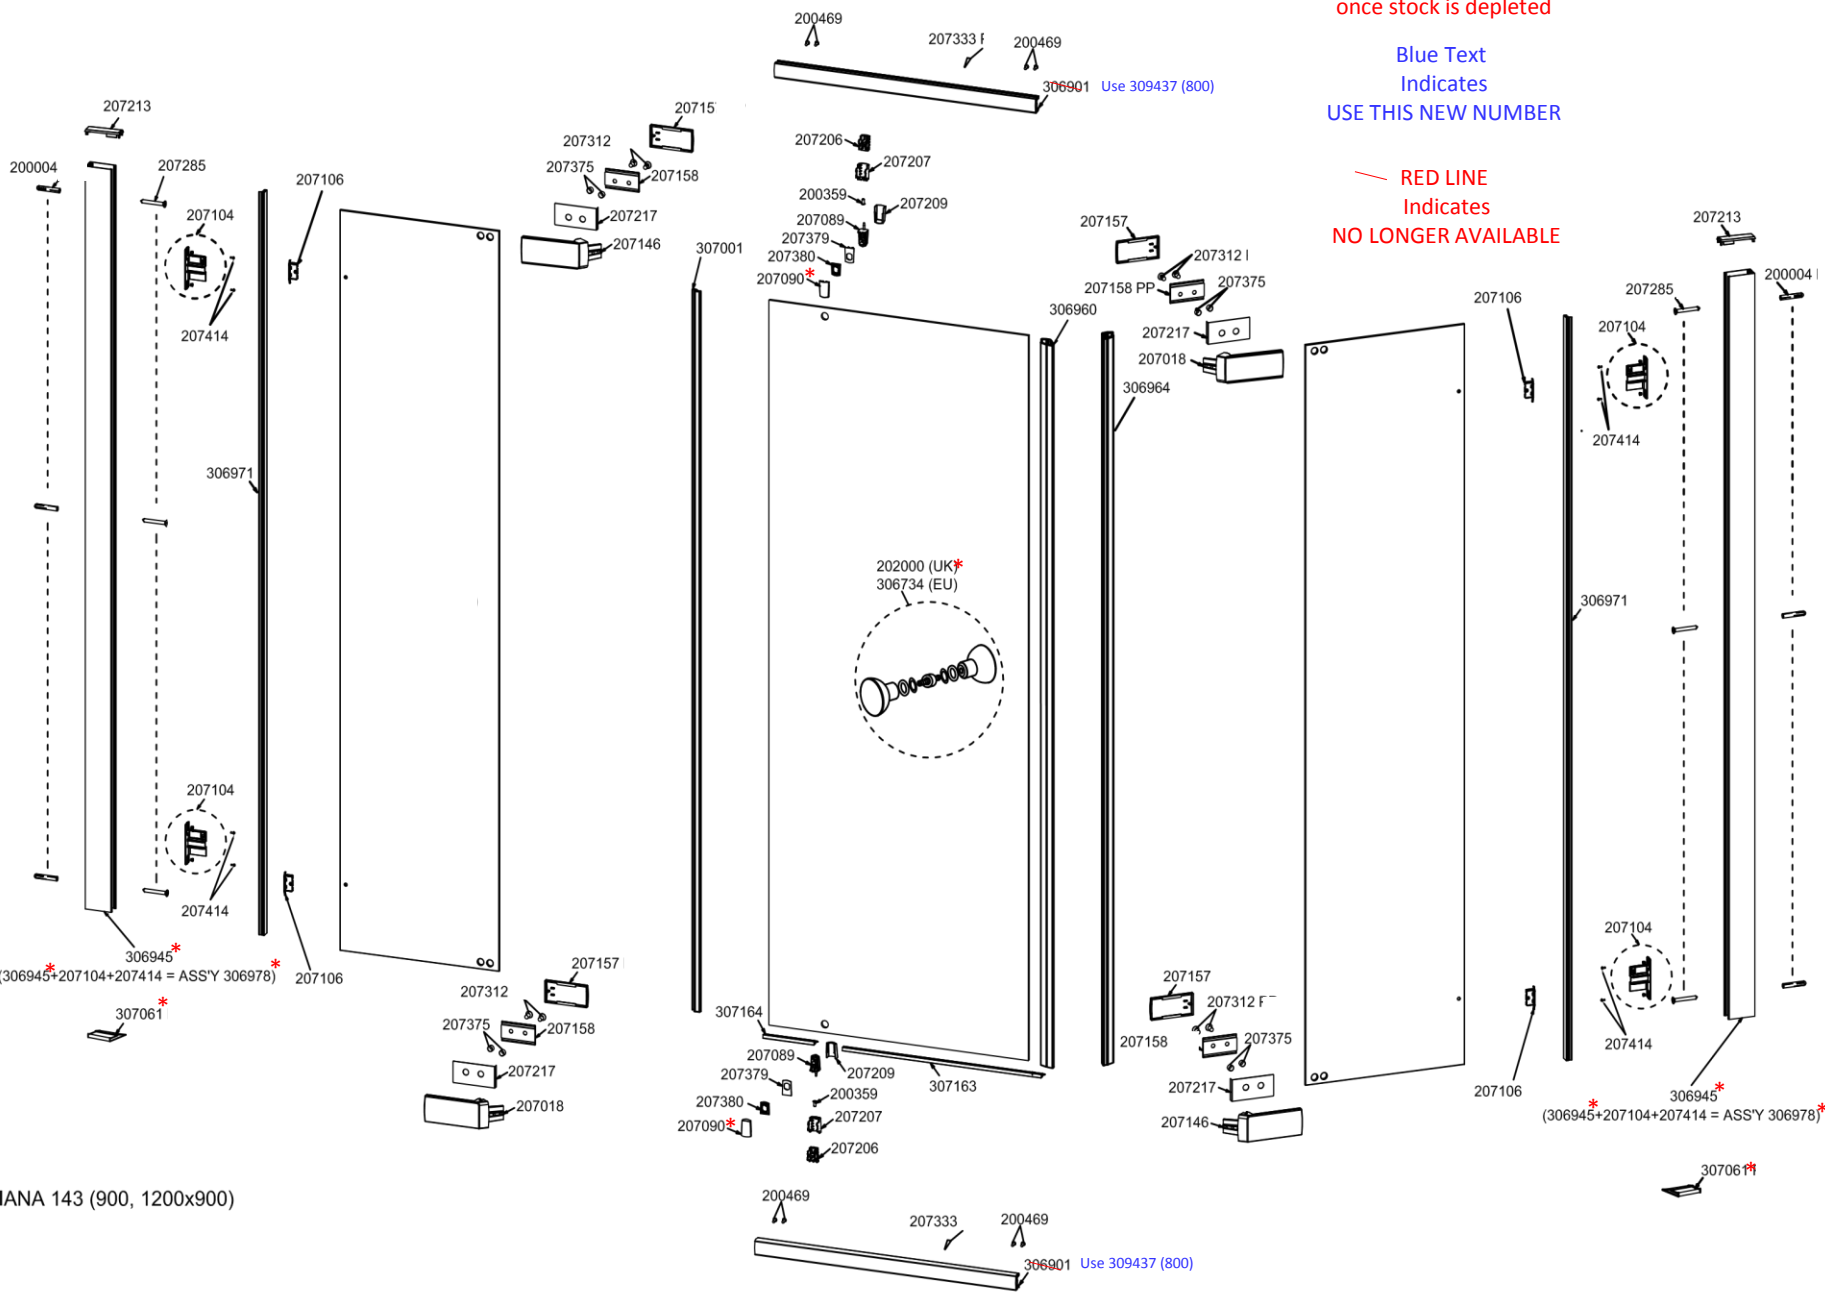

IANA 143 (900, 1200x900)