EX891–4
AROCO SLIDING DOOR

FINAL STOCK

* = No more can be supplied once stock is depleted

RED LINE Indicates NO LONGER AVAILABLE

Blue Text Indicates USE THIS NEW NUMBER

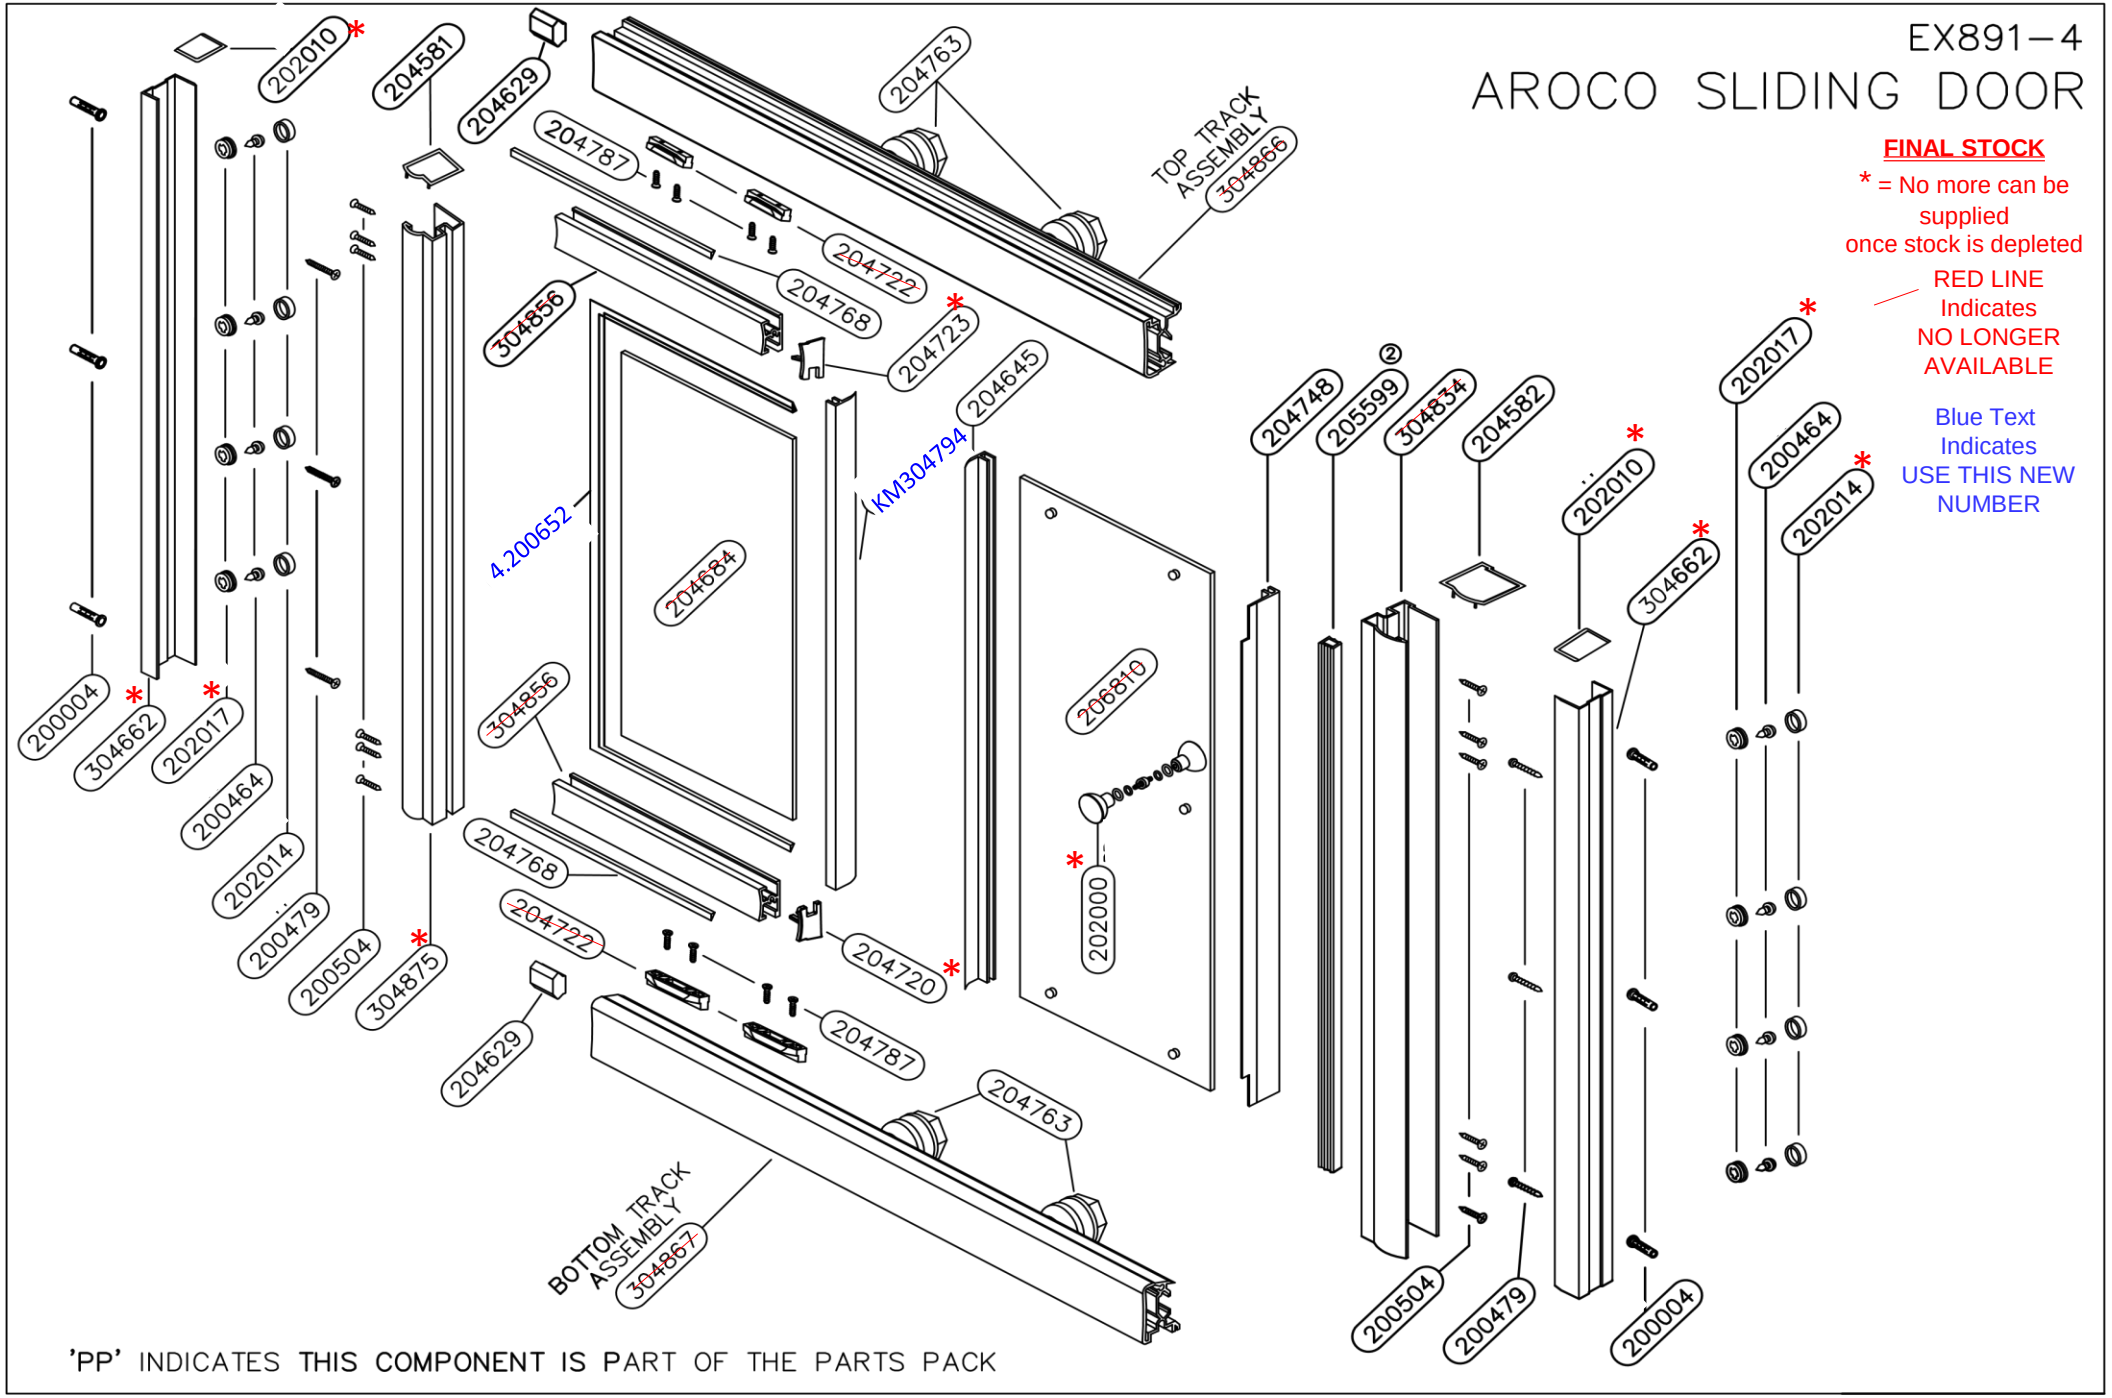

'PP' INDICATES THIS COMPONENT IS PART OF THE PARTS PACK