FINAL STOCK

* = No more can be supplied once stock is depleted

RED LINE
Indicates
NO LONGER AVAILABLE
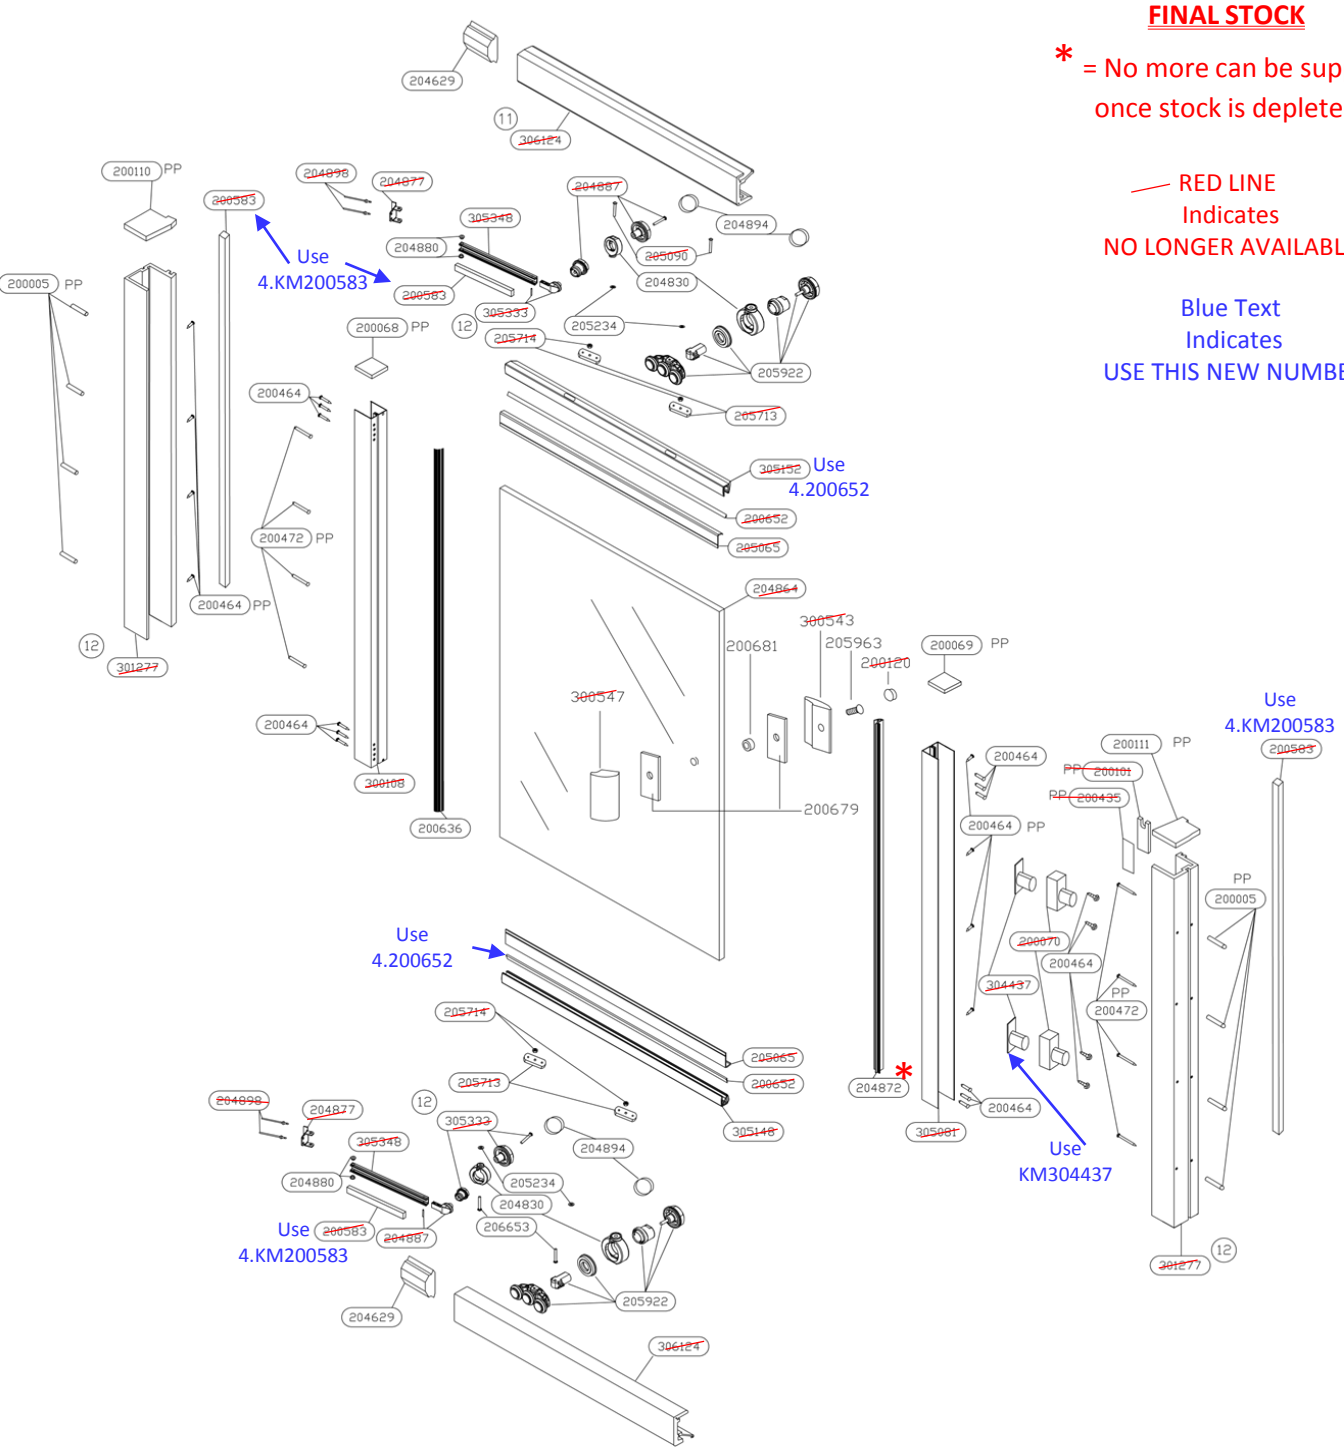
Blue Text
Indicates
USE THIS NEW NUMBER