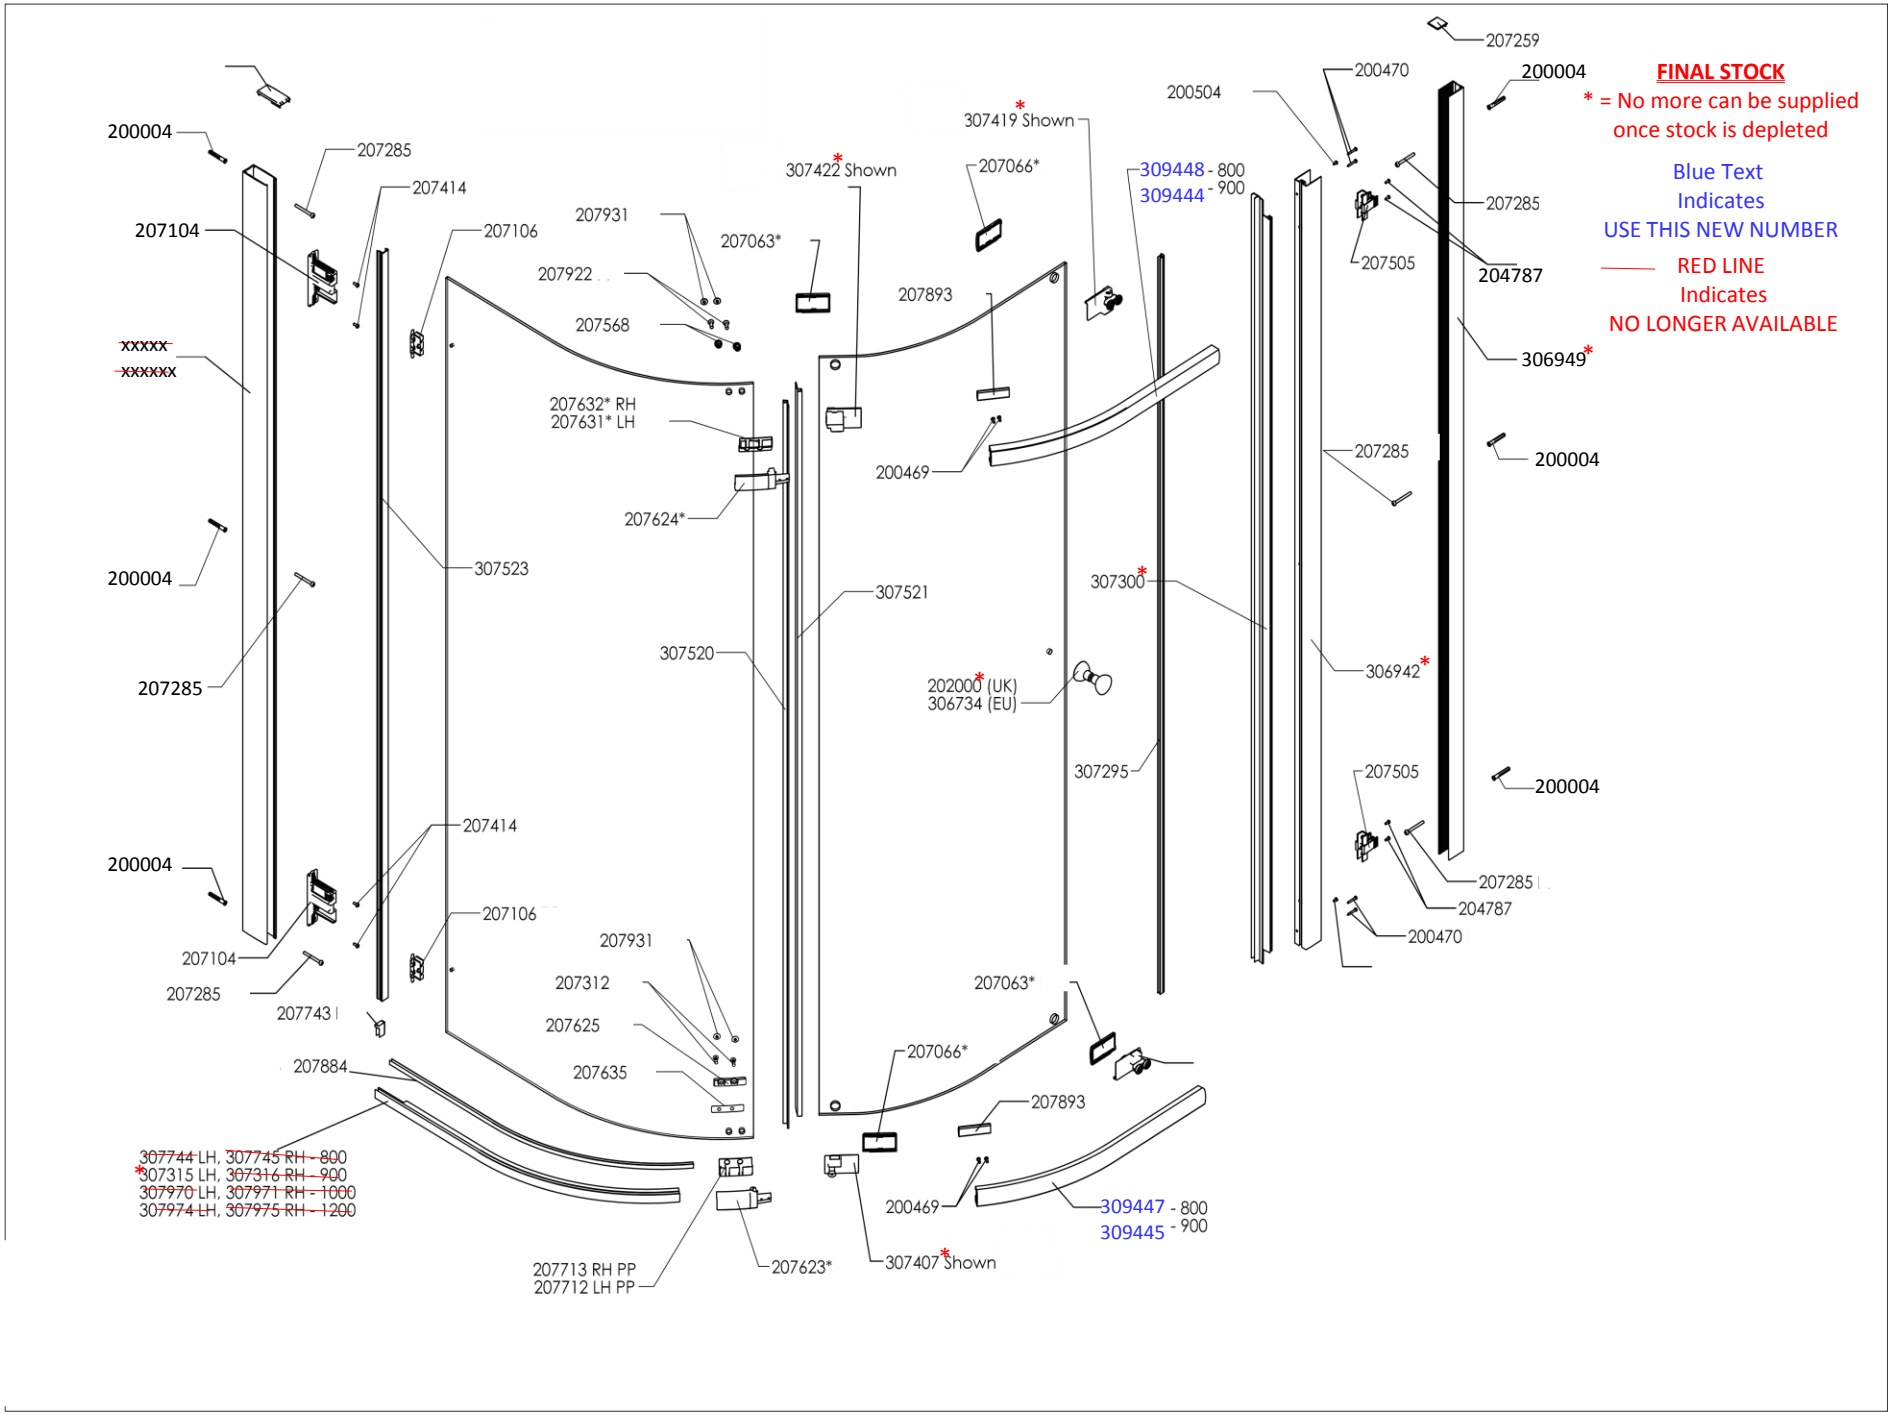
FINAL STOCK
* = No more can be supplied once stock is depleted
Blue Text Indicates USE THIS NEW NUMBER
RED LINE Indicates NO LONGER AVAILABLE
207259
200470
200004
200504
307419* Shown
307422* Shown
207066*
309448 - 800
309444 - 900
207285
207505
204787
306949*
200004
207285
200004
207285
207414
207104
207106
207931
207063*
207922
207568
207893
xxxxx
xxxxxx
207632* RH
207631* LH
200469
207624*
200004
307523
307521
307300*
307520
202000* (UK)
306734 (EU)
306942*
207285
307295
207505
200004
207414
200004
207285
204787
200470
207106
207104
207931
207285
207312
207743
207625
207063*
207635
207066*
207884
207893
307744 LH, 307745 RH - 800
*307315 LH, 307316 RH - 900
307970 LH, 307971 RH - 1000
307974 LH, 307975 RH - 1200
200469
309447 - 800
309445 - 900
207713 RH PP
207712 LH PP
207623*
307407* Shown