FINAL STOCK

* = No more can be supplied once stock is depleted

RED LINE Indicates NO LONGER AVAILABLE

EX181(762 800 900)-12

Blue Text Indicates USE THIS NEW NUMBER

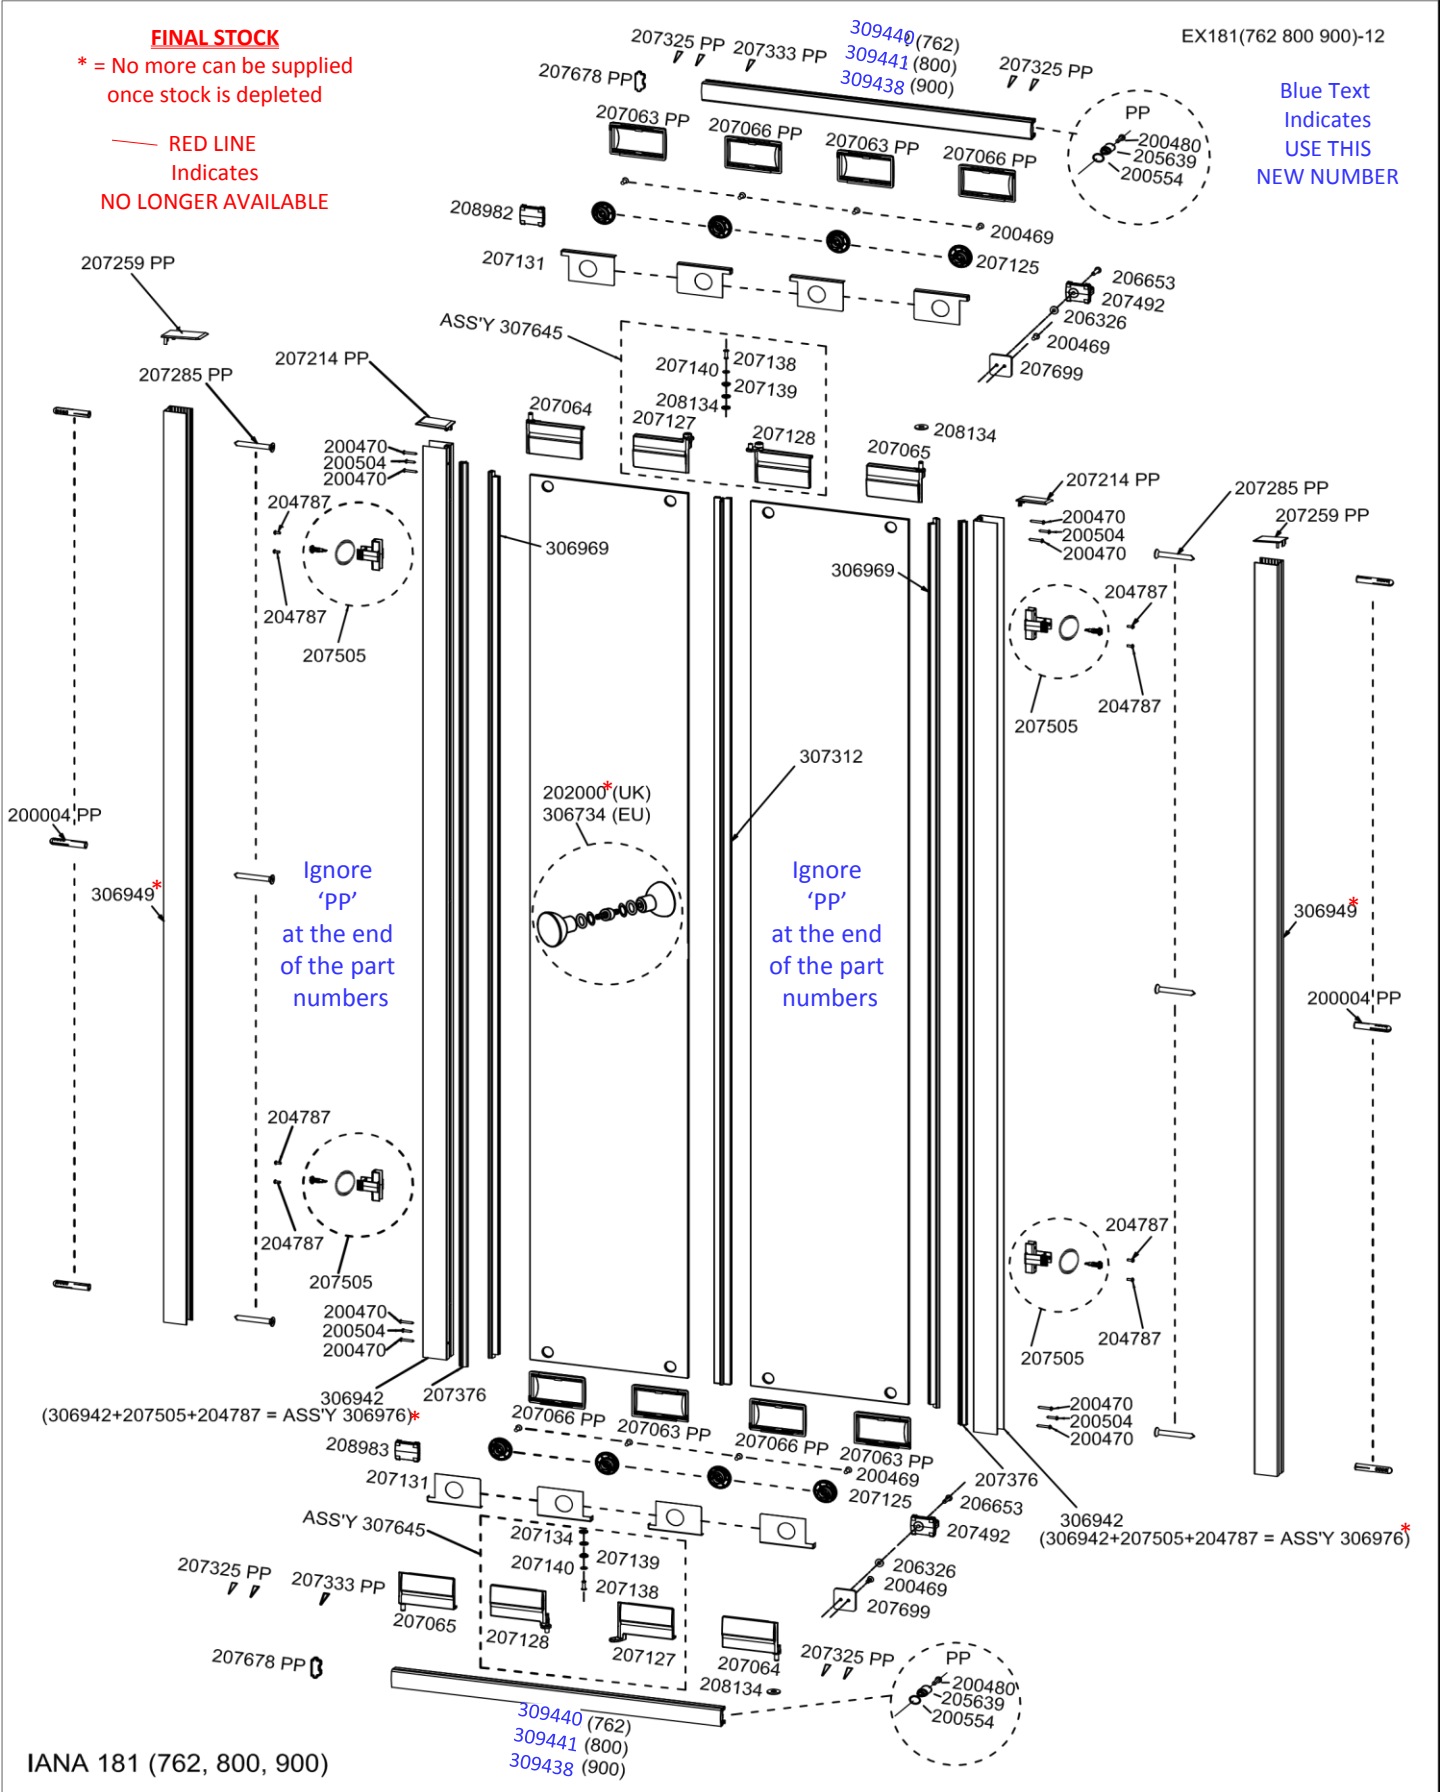

IANA 181 (762, 800, 900)

To ensure correct replacement parts are sent be ready to quote the six digit code from this drawing e.g. 304781