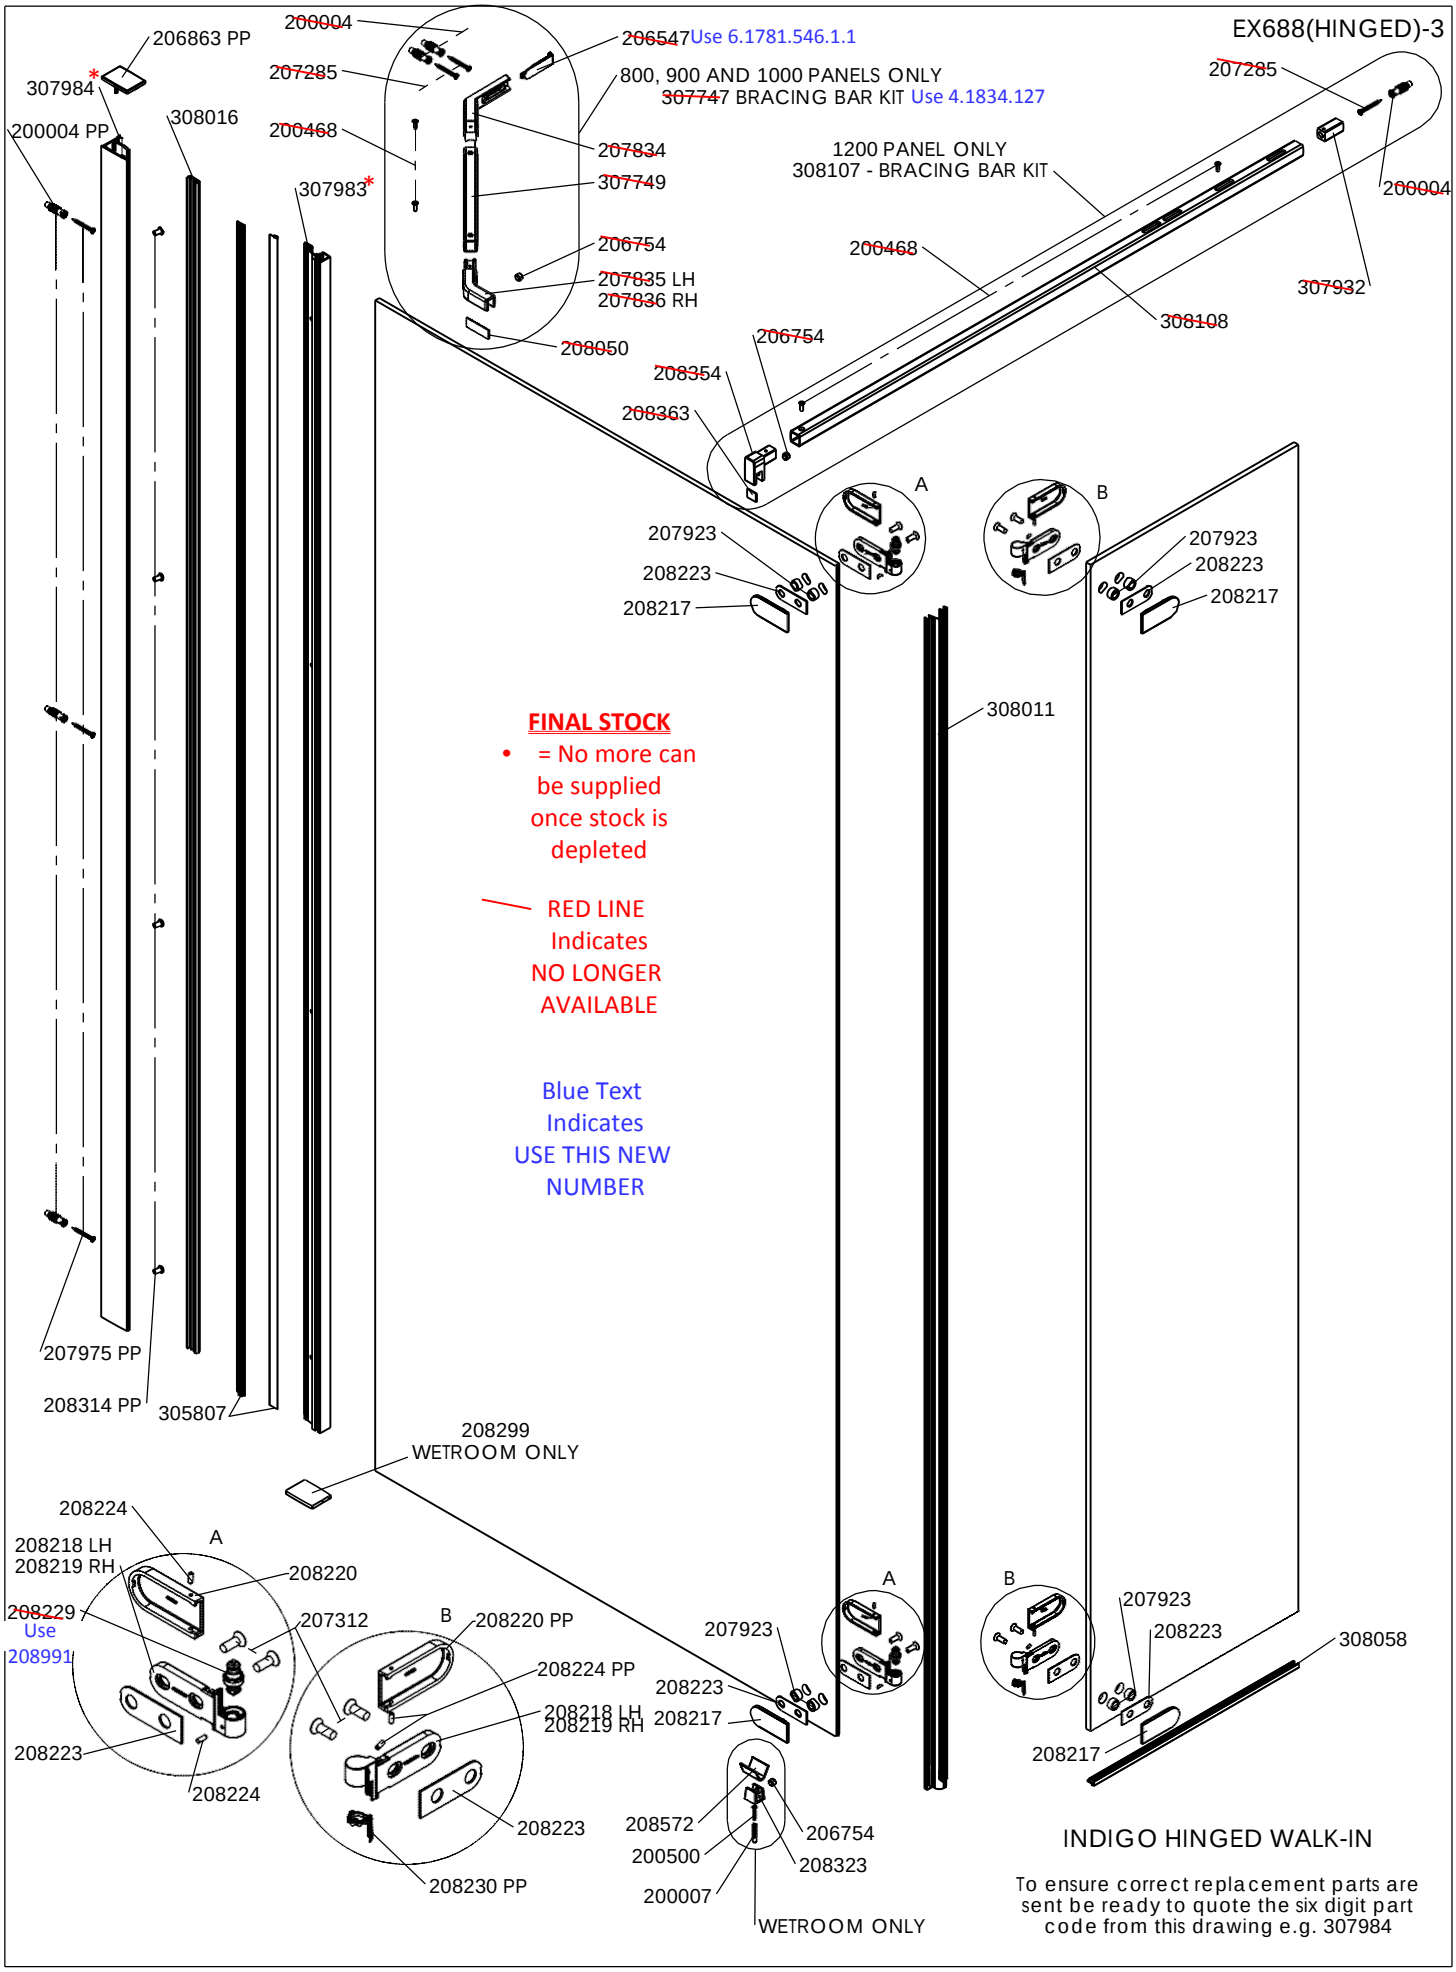
EX688(HINGED)-3
206863 PP
307984*
200004 PP
308016
200004
207285
200468
307983*
206547 Use 6.1781.546.1.1
800, 900 AND 1000 PANELS ONLY
307747 BRACING BAR KIT Use 4.1834.127
207834
307749
206754
207835 LH
207836 RH
208050
1200 PANEL ONLY
308107 - BRACING BAR KIT
207285
200004
200468
307932
308108
206754
208354
208363
A
B
207923
208223
208217
207923
208223
208217
308011
FINAL STOCK
• = No more can be supplied once stock is depleted
RED LINE Indicates NO LONGER AVAILABLE
Blue Text Indicates USE THIS NEW NUMBER
207975 PP
208314 PP
305807
208299
WETROOM ONLY
208224
208218 LH
208219 RH
A
208220
208229
Use
208991
207312
B
208220 PP
208224 PP
208218 LH
208219 RH
208223
208224
208223
208230 PP
207923
208223
208217
A
B
207923
208223
308058
208217
208572
200500
200007
206754
208323
WETROOM ONLY
INDIGO HINGED WALK-IN
To ensure correct replacement parts are sent be ready to quote the six digit part code from this drawing e.g. 307984