396 Minima Quad Slider

The codes here refer to the silver model. To ensure correct replacement parts are sent be ready to quote:

- The six digit part code from this drawing eg 305807
- The frame finish eg silver

FINAL STOCK

* = No more can be supplied once stock is depleted

RED LINE Indicates NO LONGER AVAILABLE

Blue Text Indicates USE THIS NUMBER

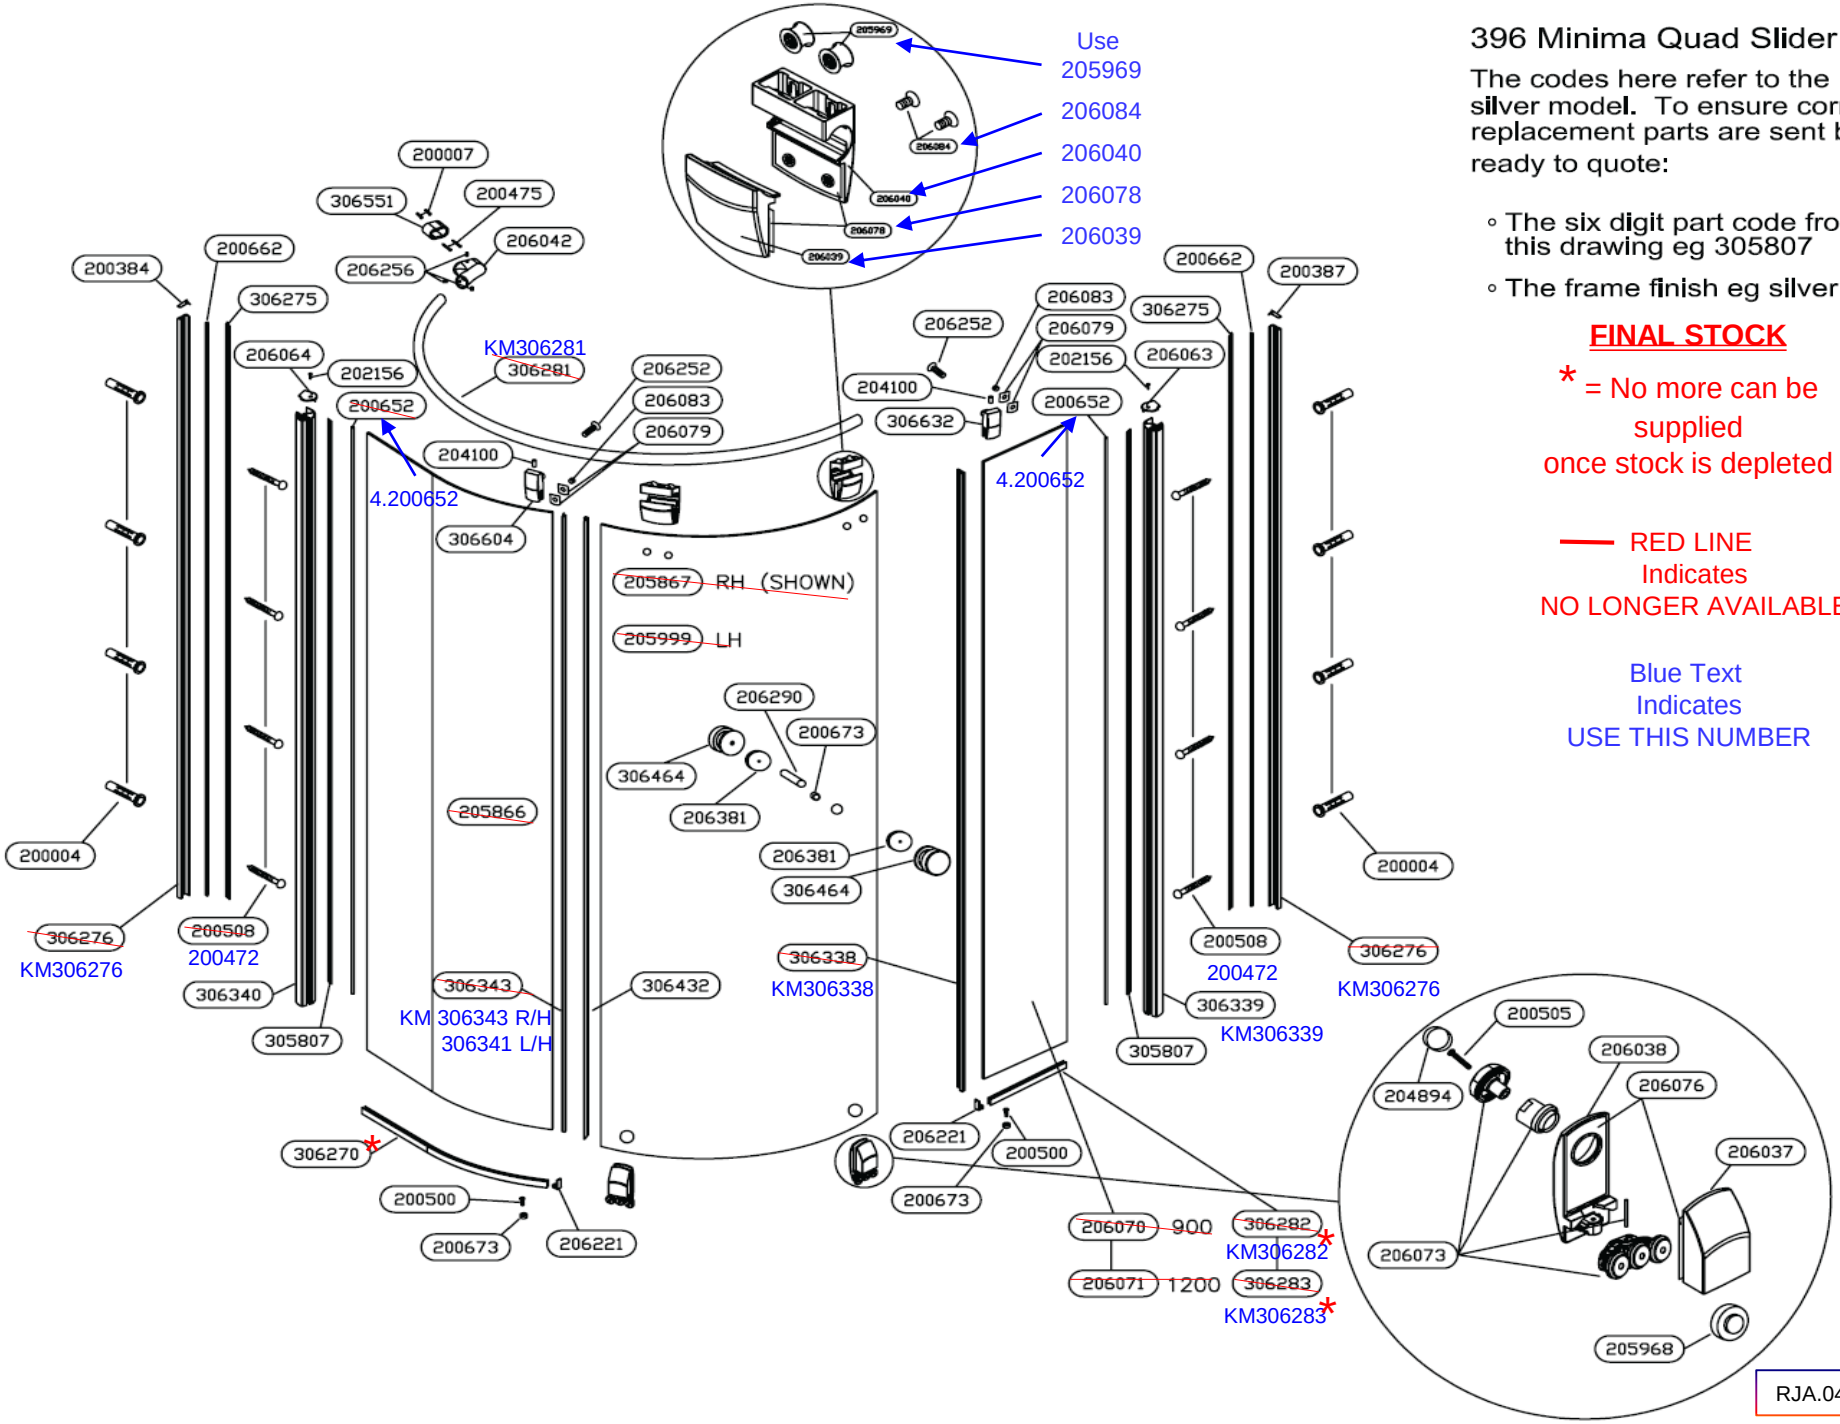

RJA.04/16